




NOTE:

- 1. AREA MEASUREMENTS ARE IN ACCORDANCE WITH BOMA 2011 FOR OFFICE BUILDINGS: STANDARD METHODS OF MEASUREMENT (ANSI/BOMA Z65.1-2011)

DATE	REVISION DETAIL
FEB 8, 2021	REVISED FOR MEASUREMENT STANDARD
AUG 16, 2021	REVISED FOR AS BUILT IMPROVEMENTS TO SUITES 703 & 705

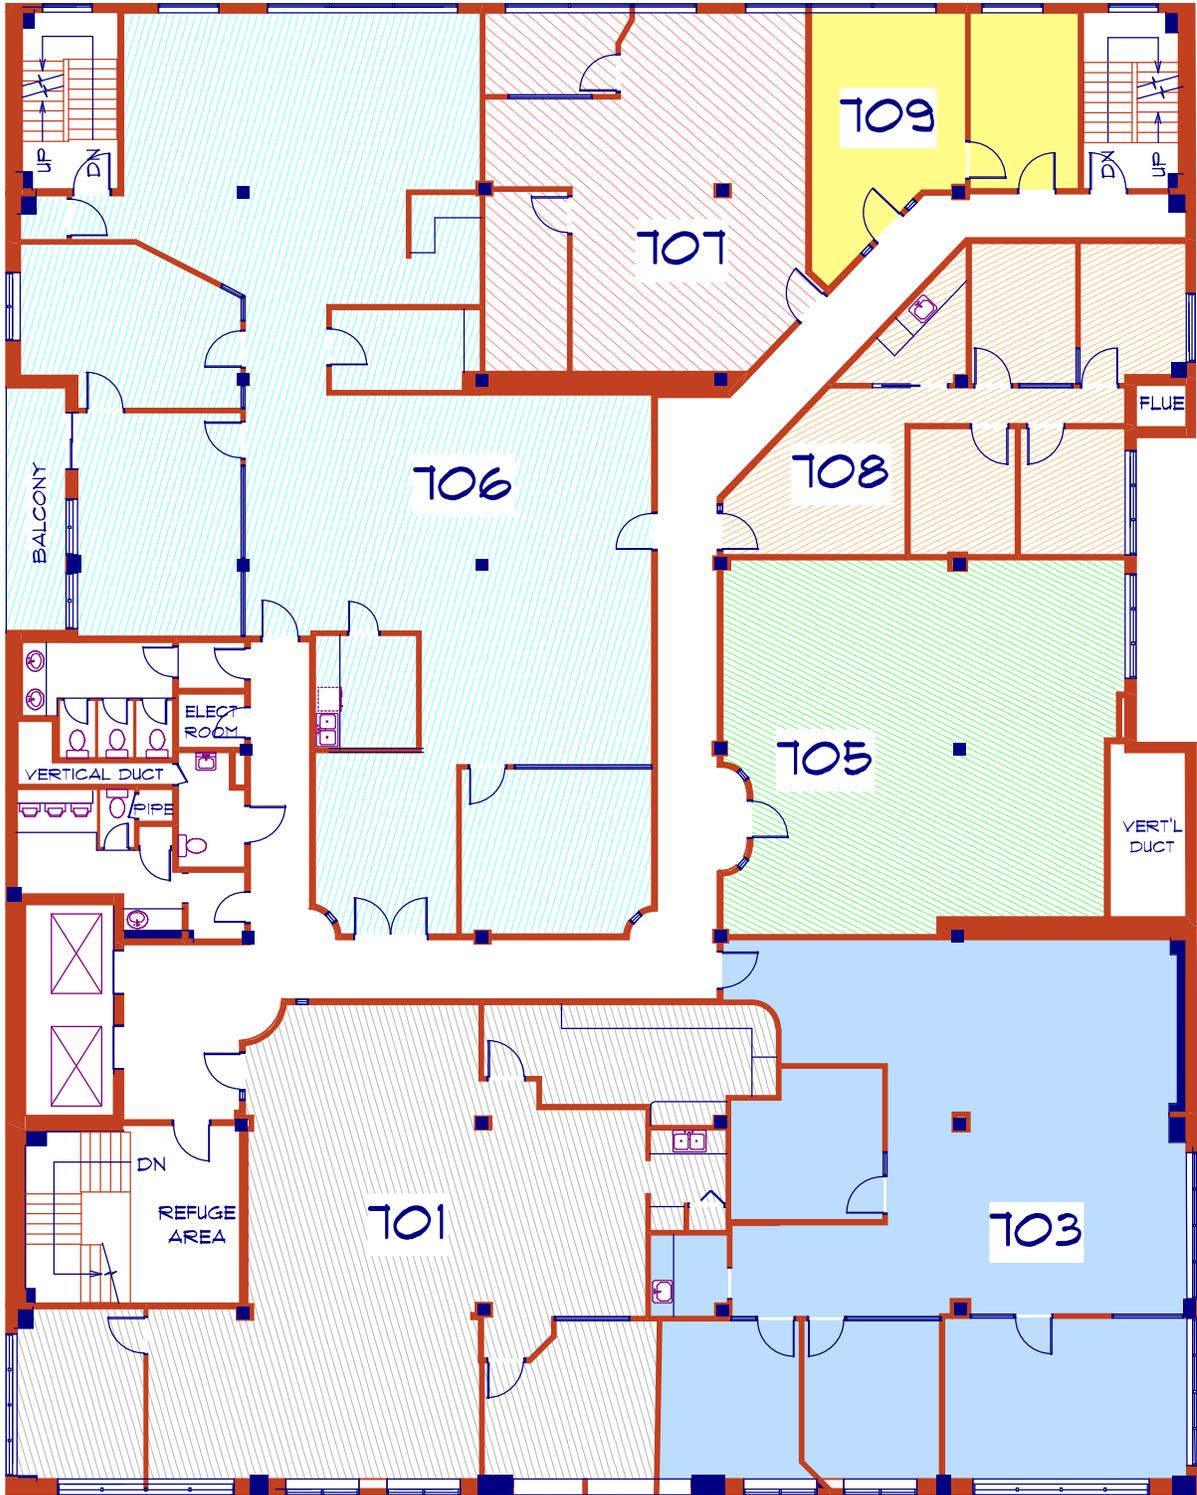


JOHN ROBSON PLACE  
 1155 ROBSON STREET  
 VANCOUVER BC  
 7th FLOOR

DRAWN BY:

GERRY PARSONS  
 FLOOR AREA MEASUREMENT TECHNICIAN



MARCH 18, 2011

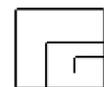

the Parsons Group  
 Delta BC  
 604-512-1203  
 www.theparsonsgroup.ca